


Gail Anderson
 1375 Dybka Townline rd
 Cherry Creek N.Y.
 Home

Driveway

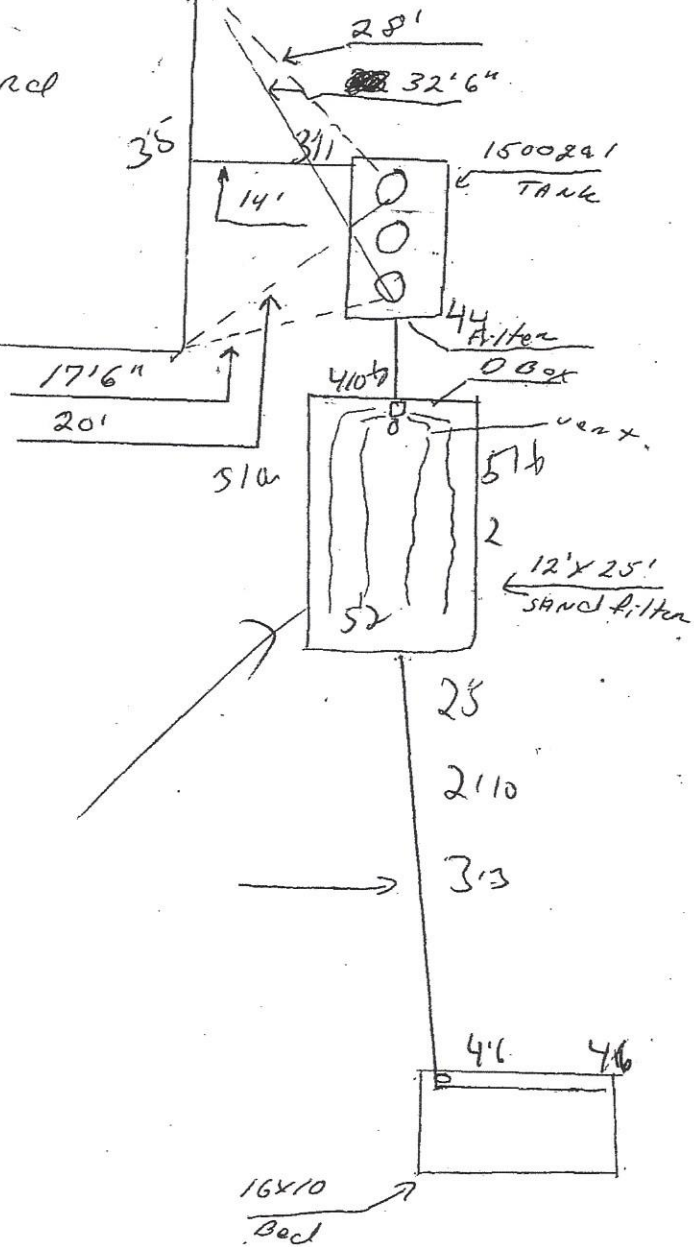

20' x 14'

Dybka Townline rd East →